
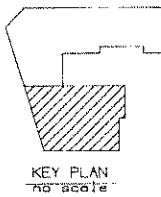


4513-A  
 COLLEGE AVENUE  
 COLLEGE PARK, MARYLAND  
**Asian Grill**  
 1338 SF

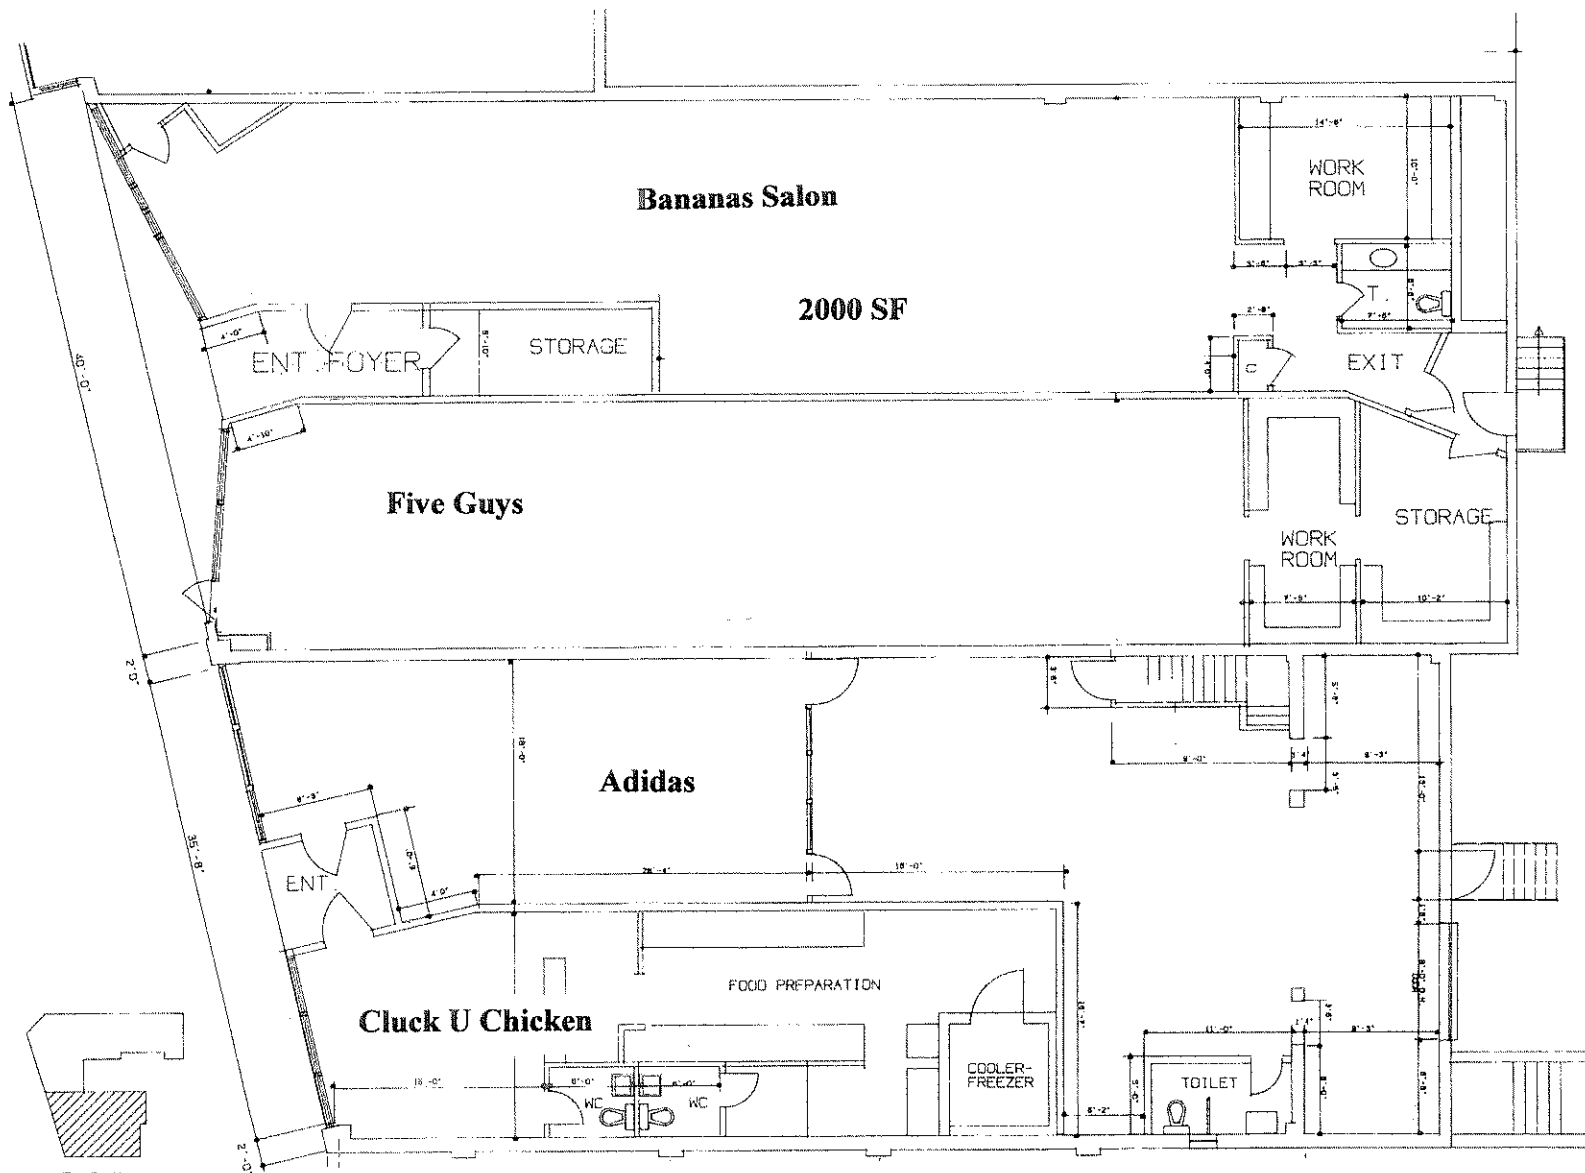

COLLEGE PARK SHOPPING CENTER  
PARTIAL FIRST FLOOR PLAN

DARCY DINIZ - ARCHITECT  
AS BUILT DRAWINGS - DATE 4/6/95